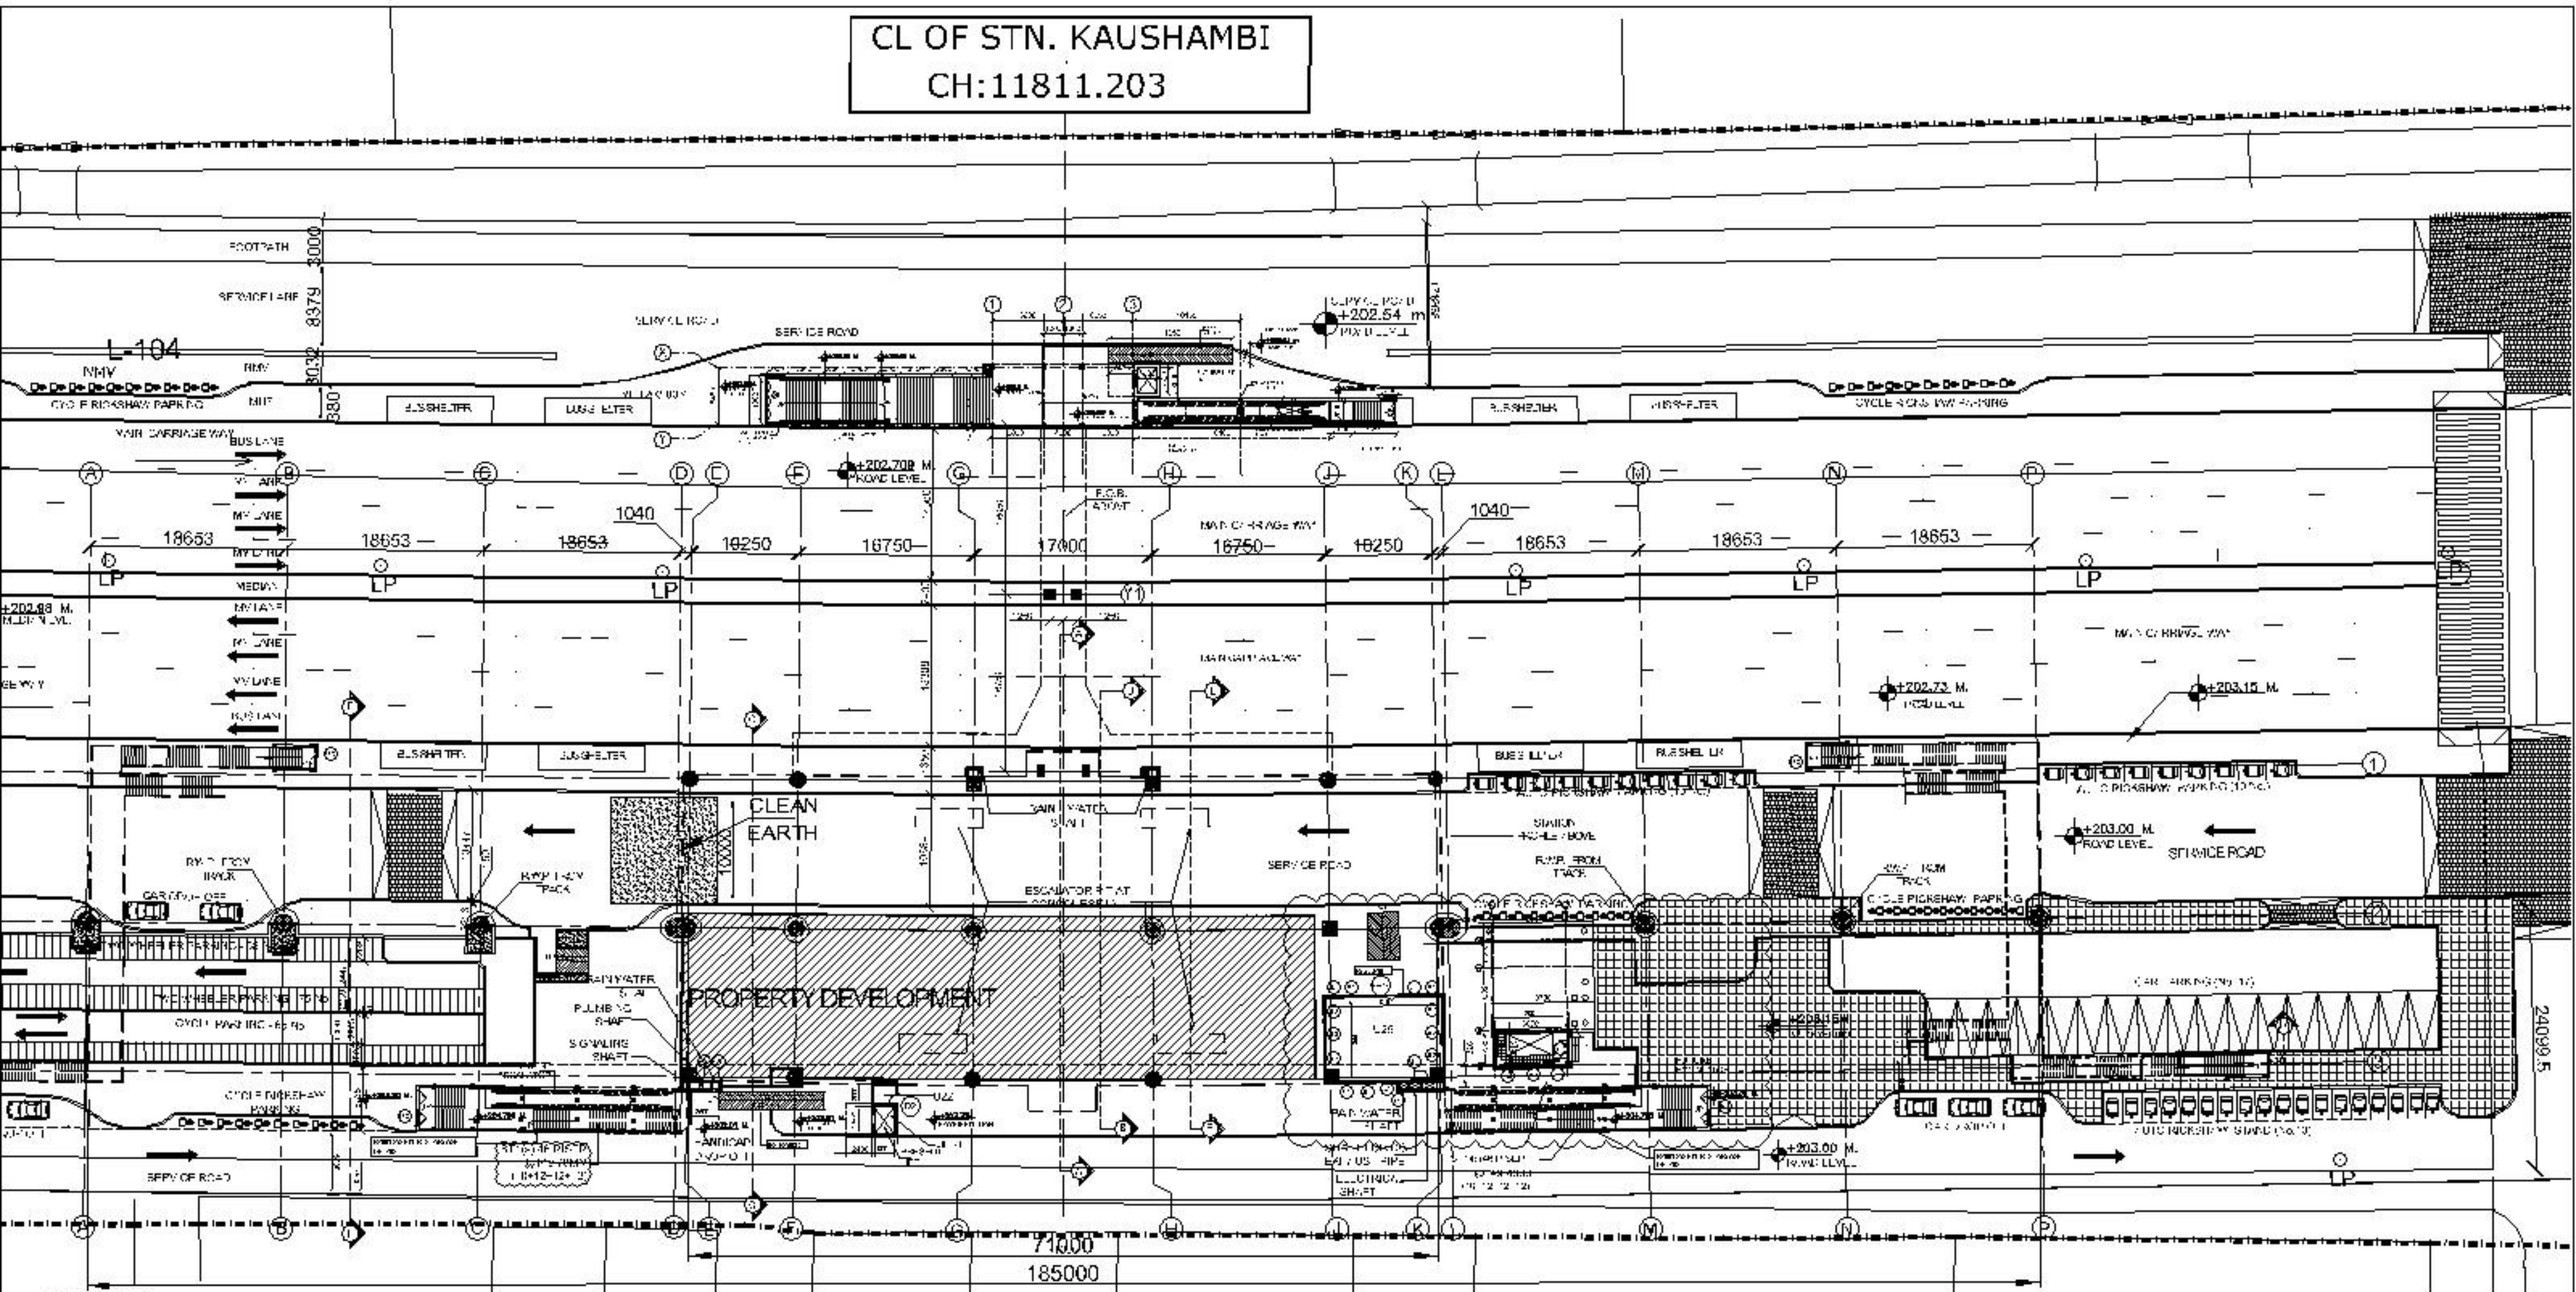

ROOM SCHEDULE

DC.NO	TYPE OF ROOM	DIM.	AREA (SQ.MT)
V01	REMIE ROOM	2.04 x 1.88	3.78
V02	D.C SET	11.01 x 7.68	84.58

REFERENCE DRAWINGS	SHEET NO.
CONCOURSE LEVEL PLAN	YB-KA-AS-A-1301
PLATFORM LEVEL PLAN	YB-KA-AS-A-1401
ROOF LEVEL PLAN	YB-KA-AS-A-1501
SECTIONS	YB-KA-AS-A-1701 TO YB-KA-AS-A-1708

GROUND LEVEL DOOR & WINDOW SCHEDULE

D/W NO.	OPENING		CILL LEVEL	LINTEL LEVEL	PARTICULARS
	**WIDTH	HEIGHT			
SFG1	2800	2800	50	2150	6 PANEL SLIDING FOLDING GATE IN M.S.
SFG2	2000	2100	50	2150	4 PANEL SLIDING FOLDING GATE IN M.S.
SFG3	2800	2800	–	2800	4 PANEL SLIDING FOLDING METAL GATE
D2	1050	2100	–	2100	METAL DOOR
D3	1750	2100	–	2100	METAL DOOR
JL1	1500	900	1800	2800	RCC JALLI
JL2	2400	900	1850	2550	RCC JALLI
JL3	2100	900	1800	2800	RCC JALLI
E13	4500		2100	2550	EXHAUST FAN OPENING
SD1	800	800	1125	2025	METAL OPENABLE PANEL

NOTE:– ALL LINTEL LEVELS ARE TO BE MEASURED FROM HIGHEST FINISHED FLOOR LEVELS.
** WIDTHS MENTIONED ARE ROUGH MASONRY OPENINGS.

GENERAL NOTES

APPROVAL BY DMRC			
DY.CA III	CA	DGM/APG	DY.CSTE/APG
DY.CPM/YA	CPM/F	CE/DESIGN	DY.CE DESIGN
DY.CE S/E	CE F/G	CE PLNG	DY.CE PLNG
DY.CSTE/SIG	CSTE/SIG	GM/RS	
DY.CSTE/TELE	CSTE/TELE	GM/OP	

Certified that this document has been designed and checked in accordance with DDC Quality Assurance Plan.

(Name and Designation)
Authorised signatory for DDC

It is strictly prohibited to alter or delete any information in this document or to copy or reproduce it for any purpose other than that for which it is intended.

No.	Date	Revision	Drawn	Checked	Approved
01		PLY SLD ASAT PLAT PLAN	PLNG	S.M	S.M
02		CLB PLY SLD D.C.S PLAT PLAN COMPLY SLD & PLY SLD AS-BUILT VER 01	PLNG	S.M	S.M
03		PLAT PLAN AS-BUILT	M.S	PLNG	S.M
04		GROUND LEVEL AND LEVEL	M.S	PLNG	S.M
05		SLD PLAN AS-BUILT			
06		GROUND LEVEL AND LEVEL AS-BUILT	M.S	PLNG	S.M
07		SHAFT AS-BUILT	M.S	PLNG	S.M
08		PLUMBING SHAFT AS-BUILT	M.S	PLNG	S.M
Rev.		PARTICULARS	DRN.	CHD.	APD.

REFERENCE DRAWINGS

Drawing	Description

ARCHITECTS
FOUNTAINHEAD
© 2016 MS YASH RI... NAL
NEW DELHI - 110 020
TEL: 26124040, 26124043, 26881534
FAX: 91 11 26998658
EMAIL: fountainhead@vsnl.com

DRAWN	FIRM IT
CHECKED	RKM
APPROVED	SM
DATE	25/08/09

DELHI METRO RAIL CORPORATION LTD.
PHASE II : EXTENSION UP TO VAISHALI
KAUSHAMBHI STATION
ROAD LEVEL PLAN

C–1

BADD 13

ARCHITECTURAL

YB-KA-AS-A-1201 | 1/11 | SCALE: 1:300 | STATUS: GENERAL ARRANGEMENT DRAWING